
NOV 15

CERTIFICATE OF SURVEY

for: STEPH-AN HOMES, INC.

by: ASSOCIATED SURVEYING & ENGINEERING, INC.

431-6633

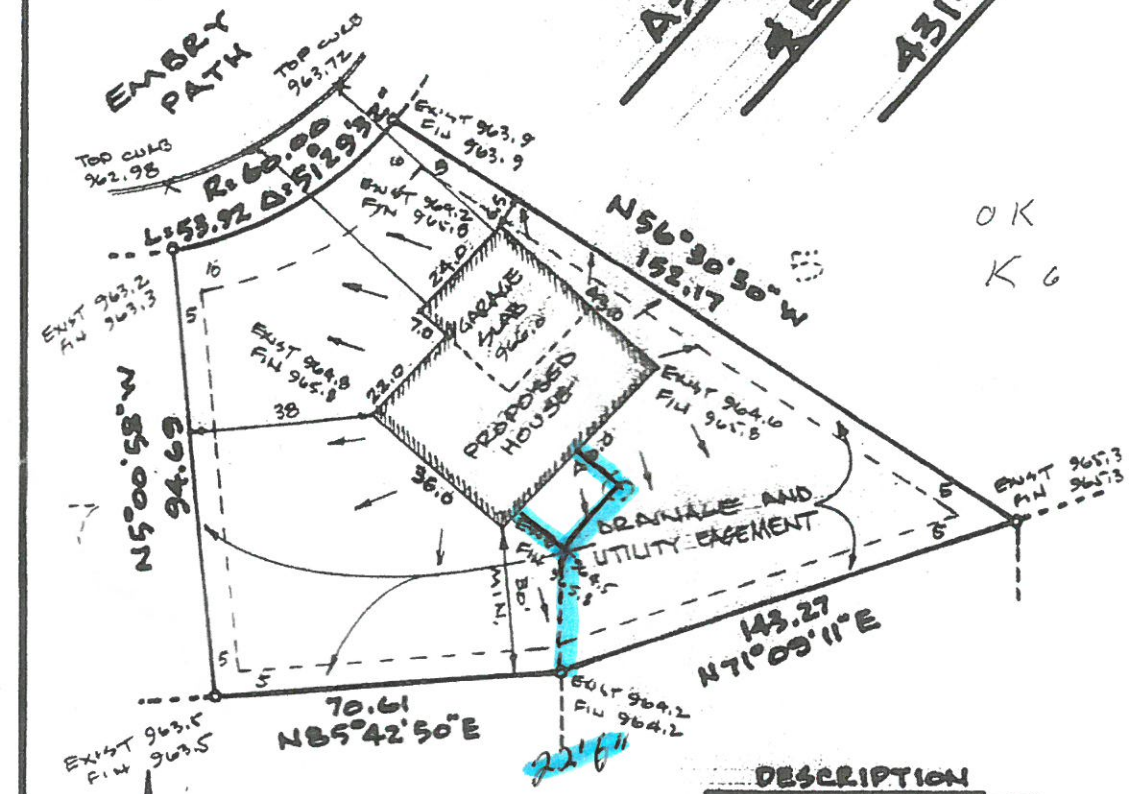

14386 Embry Ct

NORTH
SCALE 1"=30'
ALL BEARINGS ASSUMED
•DENOTES IRON MONUMENT

DESCRIPTION

LOT 6, BLOCK 1, PILOT KNOB ESTATES THIRD ADDITION, DAKATO COUNTY, MINNESOTA

I hereby certify that this survey was prepared by me or under my direct supervision and that I am a duly Registered Land Surveyor under the laws of the State of Minnesota.

Date: November 7, 1985

LeRoy H. Bohlen
Registered Land Surveyor No. 10795

Gabled Sun Room Addition
for One- and Two-Story Homes



SUN ROOM ADDITION

You Can Build It!

Included: **Complete Drawings for 3 Different Sizes**

~~12'x12'~~ 14'x~~14'~~ 16 ~~16'x16'~~

Add space and increase the value of your home with this attractive sun room addition. Carefully designed by professionals, this plan includes:

- Full Materials List
- Wall and Roof Framing Plans
- Rafter Cutting Templates
- 3-D Cutaway Drawings
- Roof Sheathing Layout
- 8/12 Gable Roof Attaches to Existing Roof or Two-Story Wall
- Includes Atrium Door, Large Windows and Half-Round Transom Window

Plan No. 90022

7 28512 90022 8

WINDOWS HAVE BEEN ORDERED & PAID FOR.